

AVAILABLE FOR LEASE


COMMERCE PLAZA

431 Commerce Park Drive
Marietta, Georgia 30060

Listing Details

- Office/Warehouse Suites
- 1,088 – 1,400 Square Feet Available
- Excellent Access to Roswell Street, Square in Marietta and Cobb Parkway. Property is located across from the Cobb County Civic Center and Lockheed Credit Union.
- Rear Overhead Doors for Warehouse Access
- Aggressive Rental Rates

Location Map

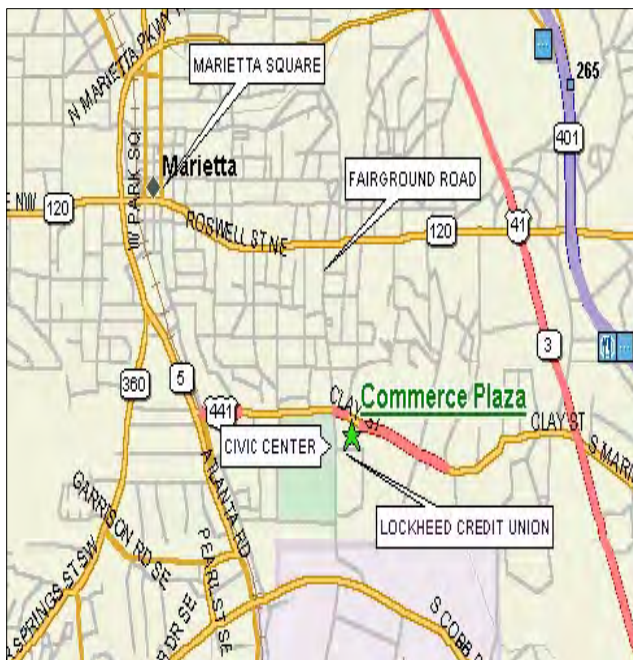

For More Information, Contact:

John Harrison

678.527.0720

jharrison@robertscommercial.com

Roberts Commercial Real Estate

9875 Medlock Bridge Parkway

Suite 200

Alpharetta, Georgia 30022

Main: 770.840.9395

Fax: 770.840.0275

www.robertscommercial.com

Roberts Commercial

REAL ESTATE SERVICES

No warranty or representation, expressed or implied, is made as to the accuracy of information contained herein. In consideration of the within information, purchaser agrees to rely solely on its right, and assumes the duty to independently obtain and analyze all information.

Roberts Commercial

REAL ESTATE SERVICES


3945 Holcomb Bridge Road Suite 203 Norcross, GA 30092
Tel 770.840.8395 Fax 770.840.0275
www.robertscommercial.com

BUILDING AREA

21,128 RSF

FLOOR PLAN

SCALE 1/32"=1'-0"

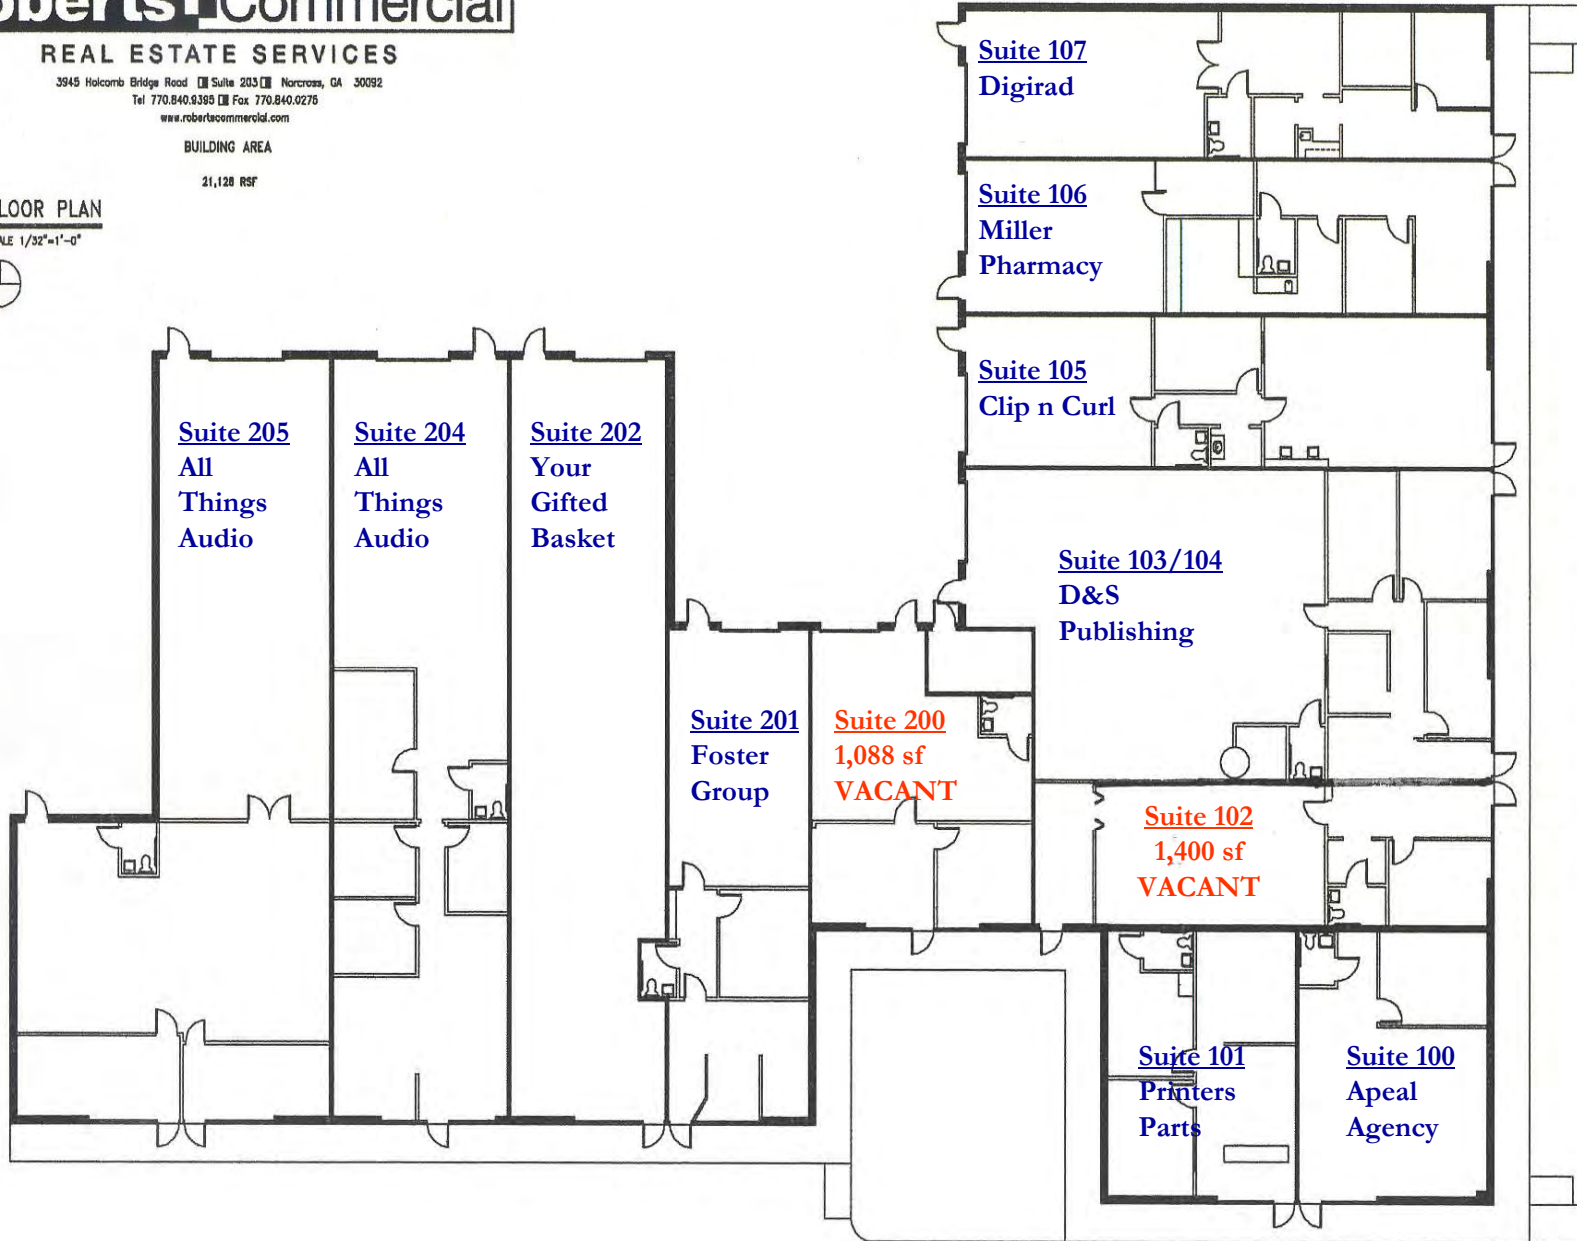

CBH PROPERTIES, LLC
431 COMMERCE PARK DRIVE, MARIETTA, GA 30060

DRAWING TYPE: AS-BUILT PLAN SCALE: 1/32"=1'-0" ISSUED BY: ISSUED DATE: 8-6-04